

409 Henry St. Lot #3

April 4, 2003


Amherst Board of Health

RE: Septic System Installation Inspection
409 Lot 3 Henry Street (new)

On this date the writer inspected the installation of a **Soil Absorption System** (septic system). The writer found the installation to be complete (except for completion of cover material and final fill) and in compliance with our plans and 310 CMR 15.000. The installer representative (**Kohl Construction**) and my inspection noted that the system was built properly, in accordance with the state regulations and our plans.

Sincerely,

Cold Spring Environmental Consultants, Inc.

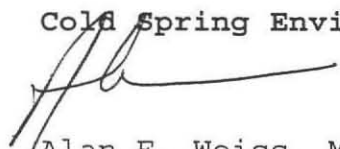

Alan E. Weiss, M.S., L.S.P.
President
Principal Hydrogeologist
Licensed Site Professional #6442
Registered Sanitarian #933

Cold Spring Environmental
350 Old Enfield Road
Belchertown, Ma. 01007

413-323-5957, phone
413-323-4916, fax

As Built Attached.

AS BUILT

PLOT PLAN

(1" = 40')

LOT 3 (#409)

(2.52 AC ± 1-)


4/4/03

BM=300.7
PIN IN 18"
PINE TREE

Proposed

302.5

300

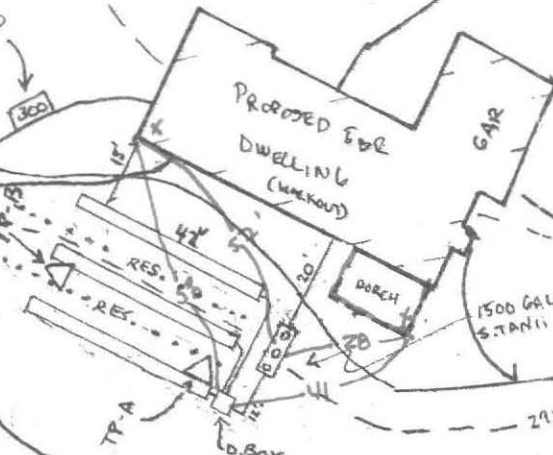

DRIVE

PROPOSED FOR
DWELLING
(UNKNOWN)

GAR

RES.

RES.

TP-A

D.BOX

295

297.50

292.5'



290

287.5'

285

302.5'

300 ← EXISTING

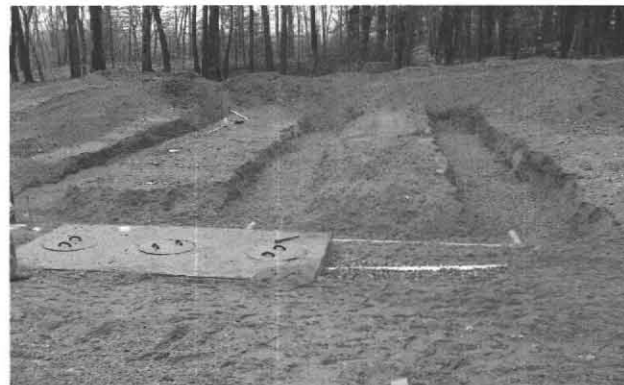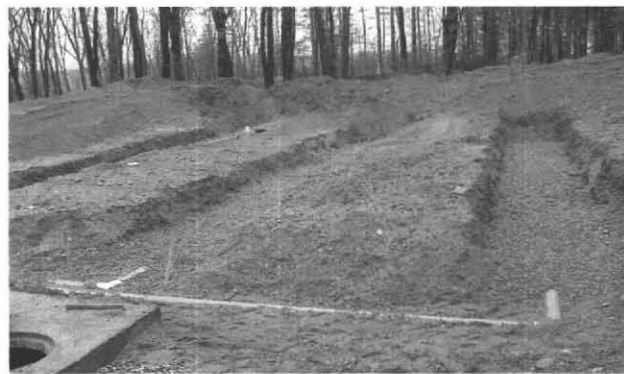

1" T has been cut to allow 3"



409 HENRY ST.

Lot #3 Henry Street Engineer: A. Wiess Installer: Kohles 4/4/03

