

BOARD OF HEALTH, AMHERST, MASSACHUSETTS
APPLICATION FOR DISPOSAL WORKS CONSTRUCTION PERMIT

#362

No. 77-7 Date 10-28-77 Fee 15.00 Date Rec'd. 10-28-77 By CEJ

Application is hereby made for a permit to Construct () or Repair () an Individual Sewage Disposal System at:

Location—Address 302 Middle St. or Lot No. 2

Owner Jeff Flower Address 9 Massasoit St. Northampton

Contractor Bob DURKEE Address FLORENCE, MA.

Type of Building _____ Dimensions _____ Size Lot 1.7 Ac.

Dwelling—No. of Bedrooms 2 Expansion Attic () Garbage Grinder ()
 Other _____ No. of persons _____ Showers ()
 Other fixtures _____

Town Water? Yes Type of Well none

Design Flow 55 gallons per person per day. Total daily flow 220 gallons
 Septic Tank—Liquid capacity 1500 gallons Dimensions: L _____ W _____ D _____

Disposal Trench—No. _____ Width _____ Total Length _____ Total leaching area _____ sq. ft.
 Disposal Bed—No. 1 Diameter 18" x 18" Depth below inlet _____ Total leaching area 450 sq. ft.

Dry Well—No. _____ Diameter 15" x 30" Depth below inlet _____ Dimensions: _____ x _____ x _____
 Other: Distribution box () No. _____ Dosing tank ()

(Depth of Soil Line Below finished grade at foundation _____)
 Percolation Test Results Performed by Frederick Filios Date Apr. 21 1977

Test Pit No. 1 2 minutes per inch Depth of Test Pit 32"
 Test Pit No. 2 _____ minutes per inch Depth of Test Pit _____

Description of Soil Provided Depth to Ground Water none at 7'6"
 Will disposal area be filled? _____ Cut down? _____

(On reverse side or separate sheet, show plot plan with building. Include dimensions, distances from all boundaries. Show location of wells, streams, ledge, large trees, etc.)

AGREEMENT: The undersigned agrees to construct the aforescribed individual sewage disposal system in accordance with the provisions of Article XI of the Sanitary Code and regulations of the Amherst Board of Health. The undersigned further agrees not to place the system in operation until a Certificate of Compliance has been issued by this board of health.

Application Approved by CEJ John V. Flower Owner or builder 10-28-77 date

Application Disapproved for the following reasons: _____ date

BOARD OF HEALTH, AMHERST, MASSACHUSETTS
CERTIFICATE OF COMPLIANCE

THIS IS TO CERTIFY, That the individual Sewage Disposal System installed () or repaired () by _____ at _____ has been constructed in accordance with the provisions of

INSTALLER
 Article XI of the State Sanitary Code as described in the application for Disposal Works Construction Permit No. _____ dated _____


The issuance of this certificate shall not be construed as a guarantee that the system will function satisfactorily.
 DATE _____ Inspector _____

BOARD OF HEALTH, AMHERST, MASSACHUSETTS
DISPOSAL WORKS CONSTRUCTION PERMIT

No. 77-7
 Permission is hereby granted JEFF FLOWER to construct (X) or repair () an Individual Sewage Disposal System at LOT # 2 MIDDLE ST (MUNICIPAL PROPERTY) as shown on the application for Disposal Works Construction Permit No. 77-7

This permit is issued with the understanding that future alterations or additions will be made if necessary. This permit shall not be construed as permission to create or maintain any sewage nuisance and in the issuance of this permit the Board of Health assumes no responsibility for the future operation or maintenance of the system.

DATE 10-28-77 CEJ Board of Health

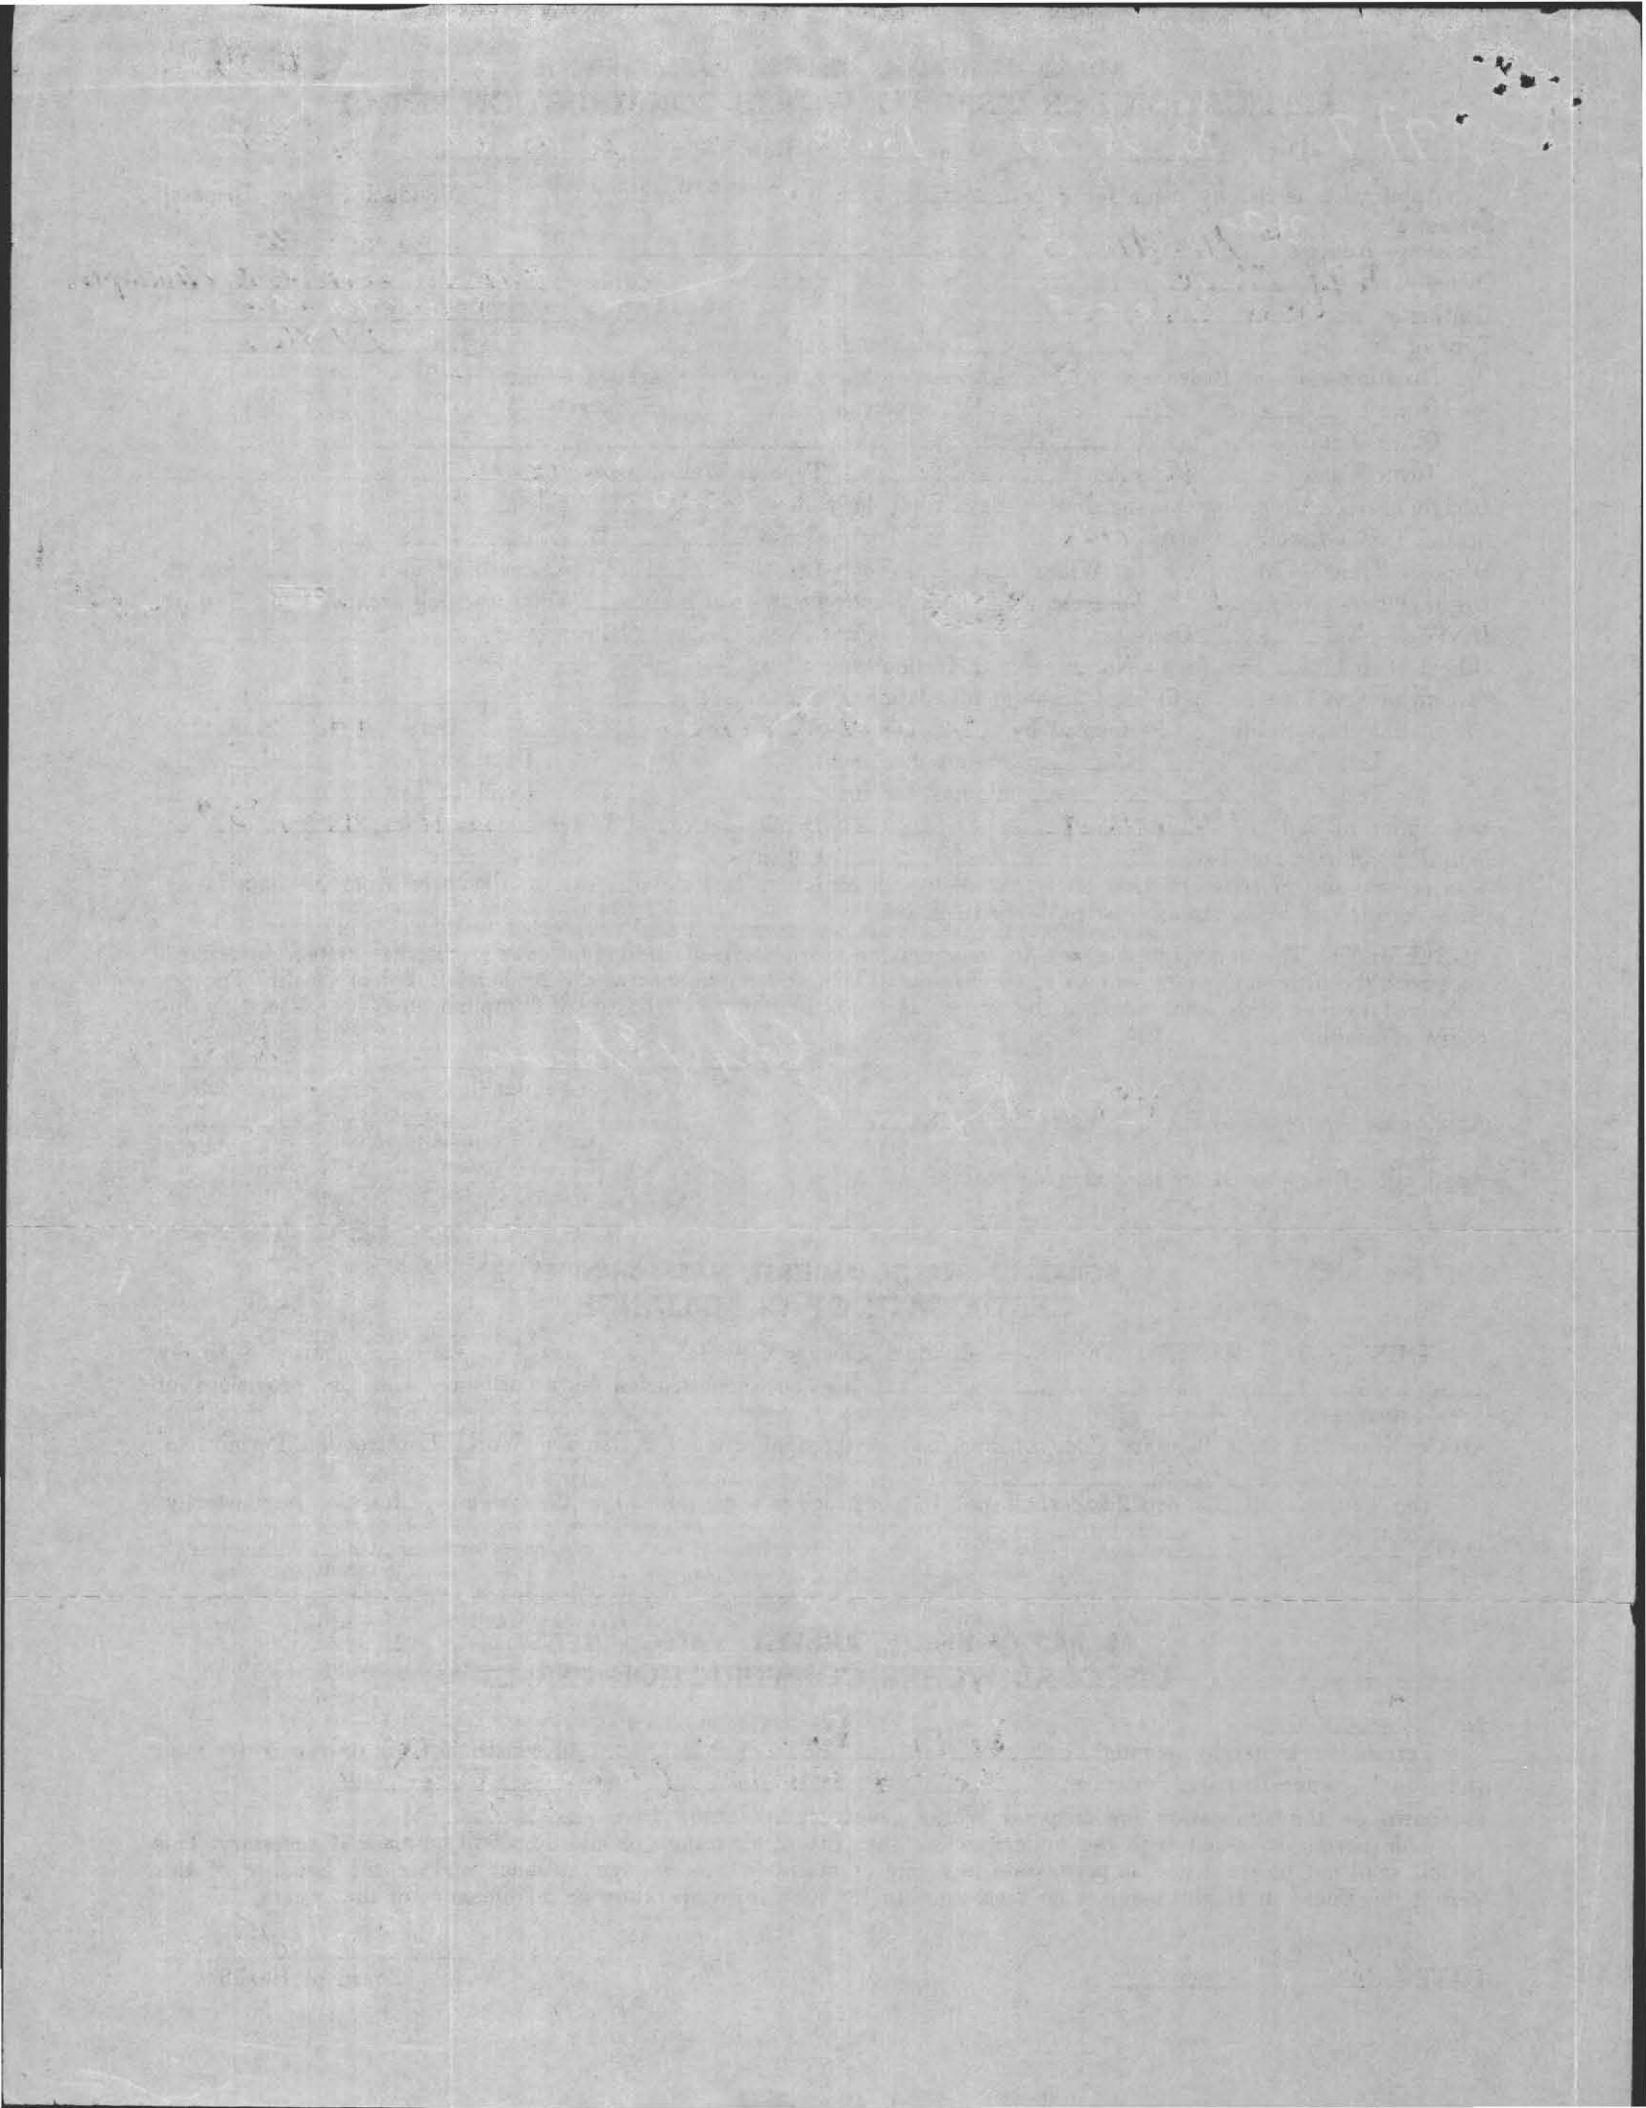

DEEP SOIL LOSS

OWNER L. Robt Mannheim


DATE Apr. 21 1977

LOCATION Middle St

OBSERVER Fred Filios


Lot #2 Jeff. Flower

Lot #3 Rate 2 min/inch

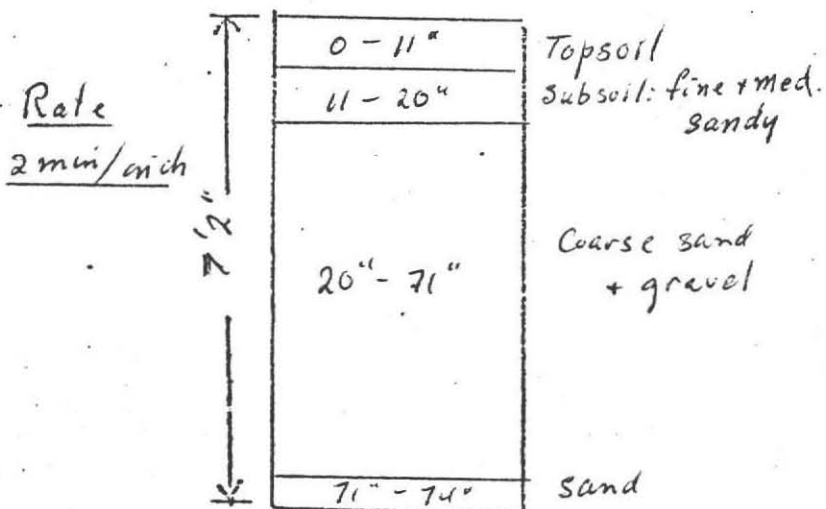


GROUND WATER none

Lot #7 Rate 2 min/inch

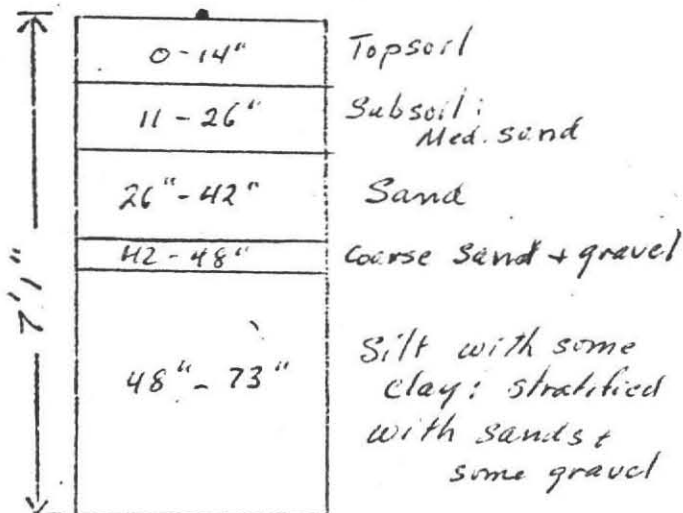


GROUND WATER 6'
seepage at 55"

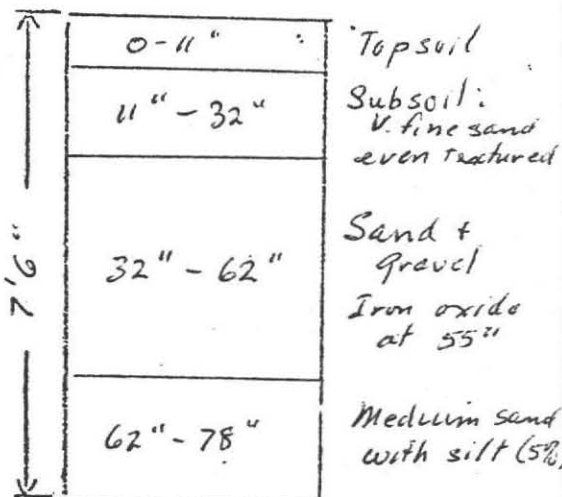

GROUND WATER 62"

Lot #8 Rate 2 min/inch

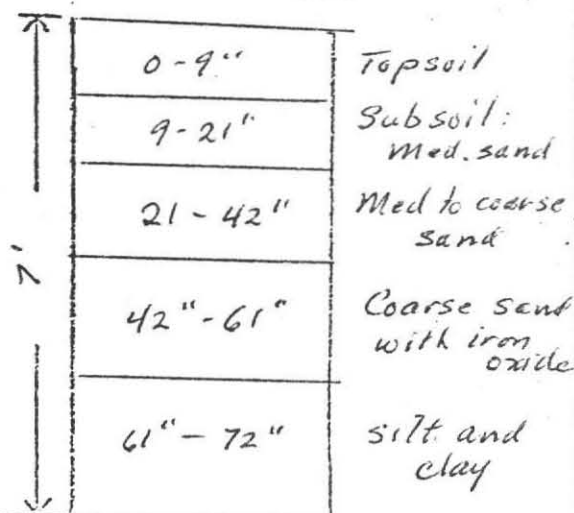

GROUND WATER 66 inches



10

Scopios

BOARD OF HEALTH
TOWN OF AMHERST, MASSACHUSETTS

Important Information Regarding Your Private Sewage Disposal System

DISPLAY THIS DOCUMENT IN A PROMINENT PLACE

Owner JEFF FLOWER
~~PETER MAY~~ Address 9 MASSACHUSETTS ST Amherst

Installer ROBERT DURKGE Address FLORENCE, MA.


Date Installation Inspected and Approved JUNE 12, 1978

Description of System: Tank Capacity: 1500

Leach Field () Bed () Seepage Pit () Square Feet: 700


Garbage Grinder Yes () No () No. Bedrooms: 4 No. People 8

As - BUILT PLAN:

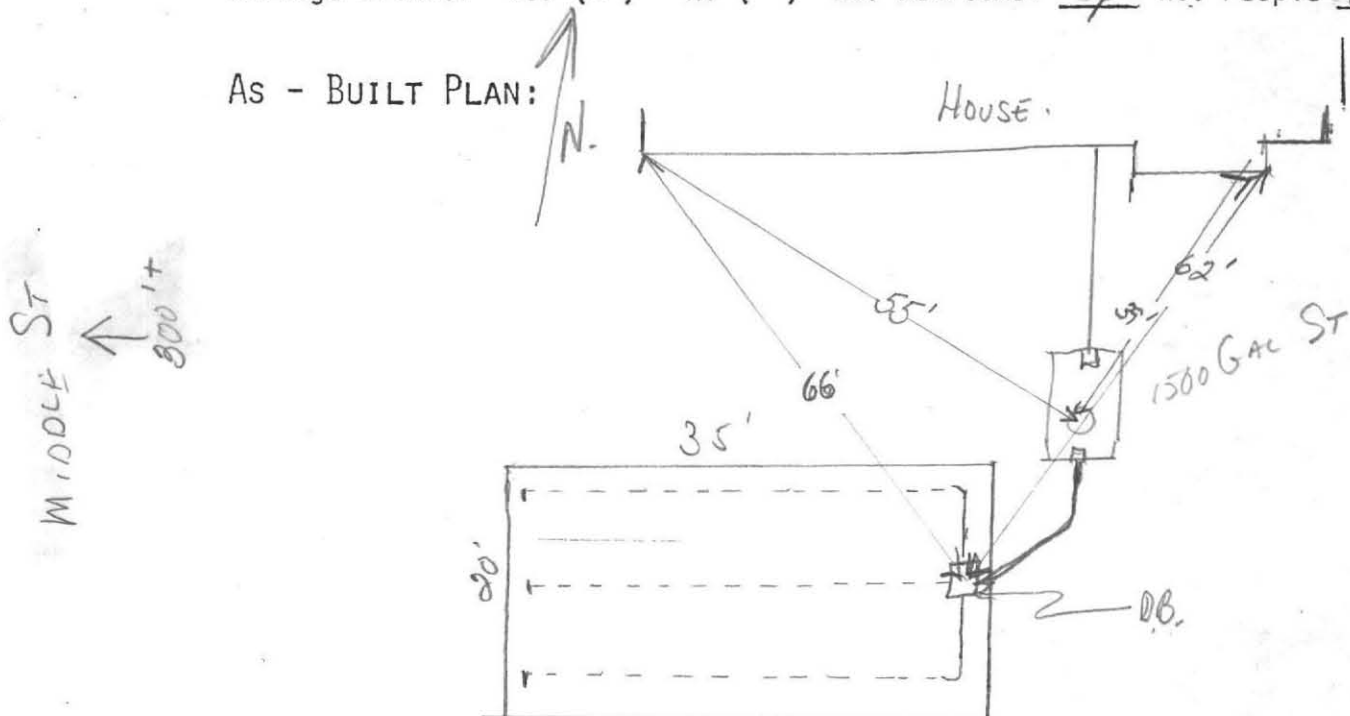

PROPER MAINTENANCE OF YOUR PRIVATE SEWAGE DISPOSAL SYSTEM

1. This system must be inspected periodically and the tank pumped out at an interval not to exceed 3 years.
2. For your protection sanitary pumpers are licensed by the Amherst Board of Health.
3. Regular pumping is crucial to avoid early failure and costly repairs of the system.
4. DO NOT dispose into the system such items as rags, string, sanitary napkins, coffee grounds as they can cause it to clog and fail.
5. Further information can be obtained by contacting your Health Department at 253-7077.

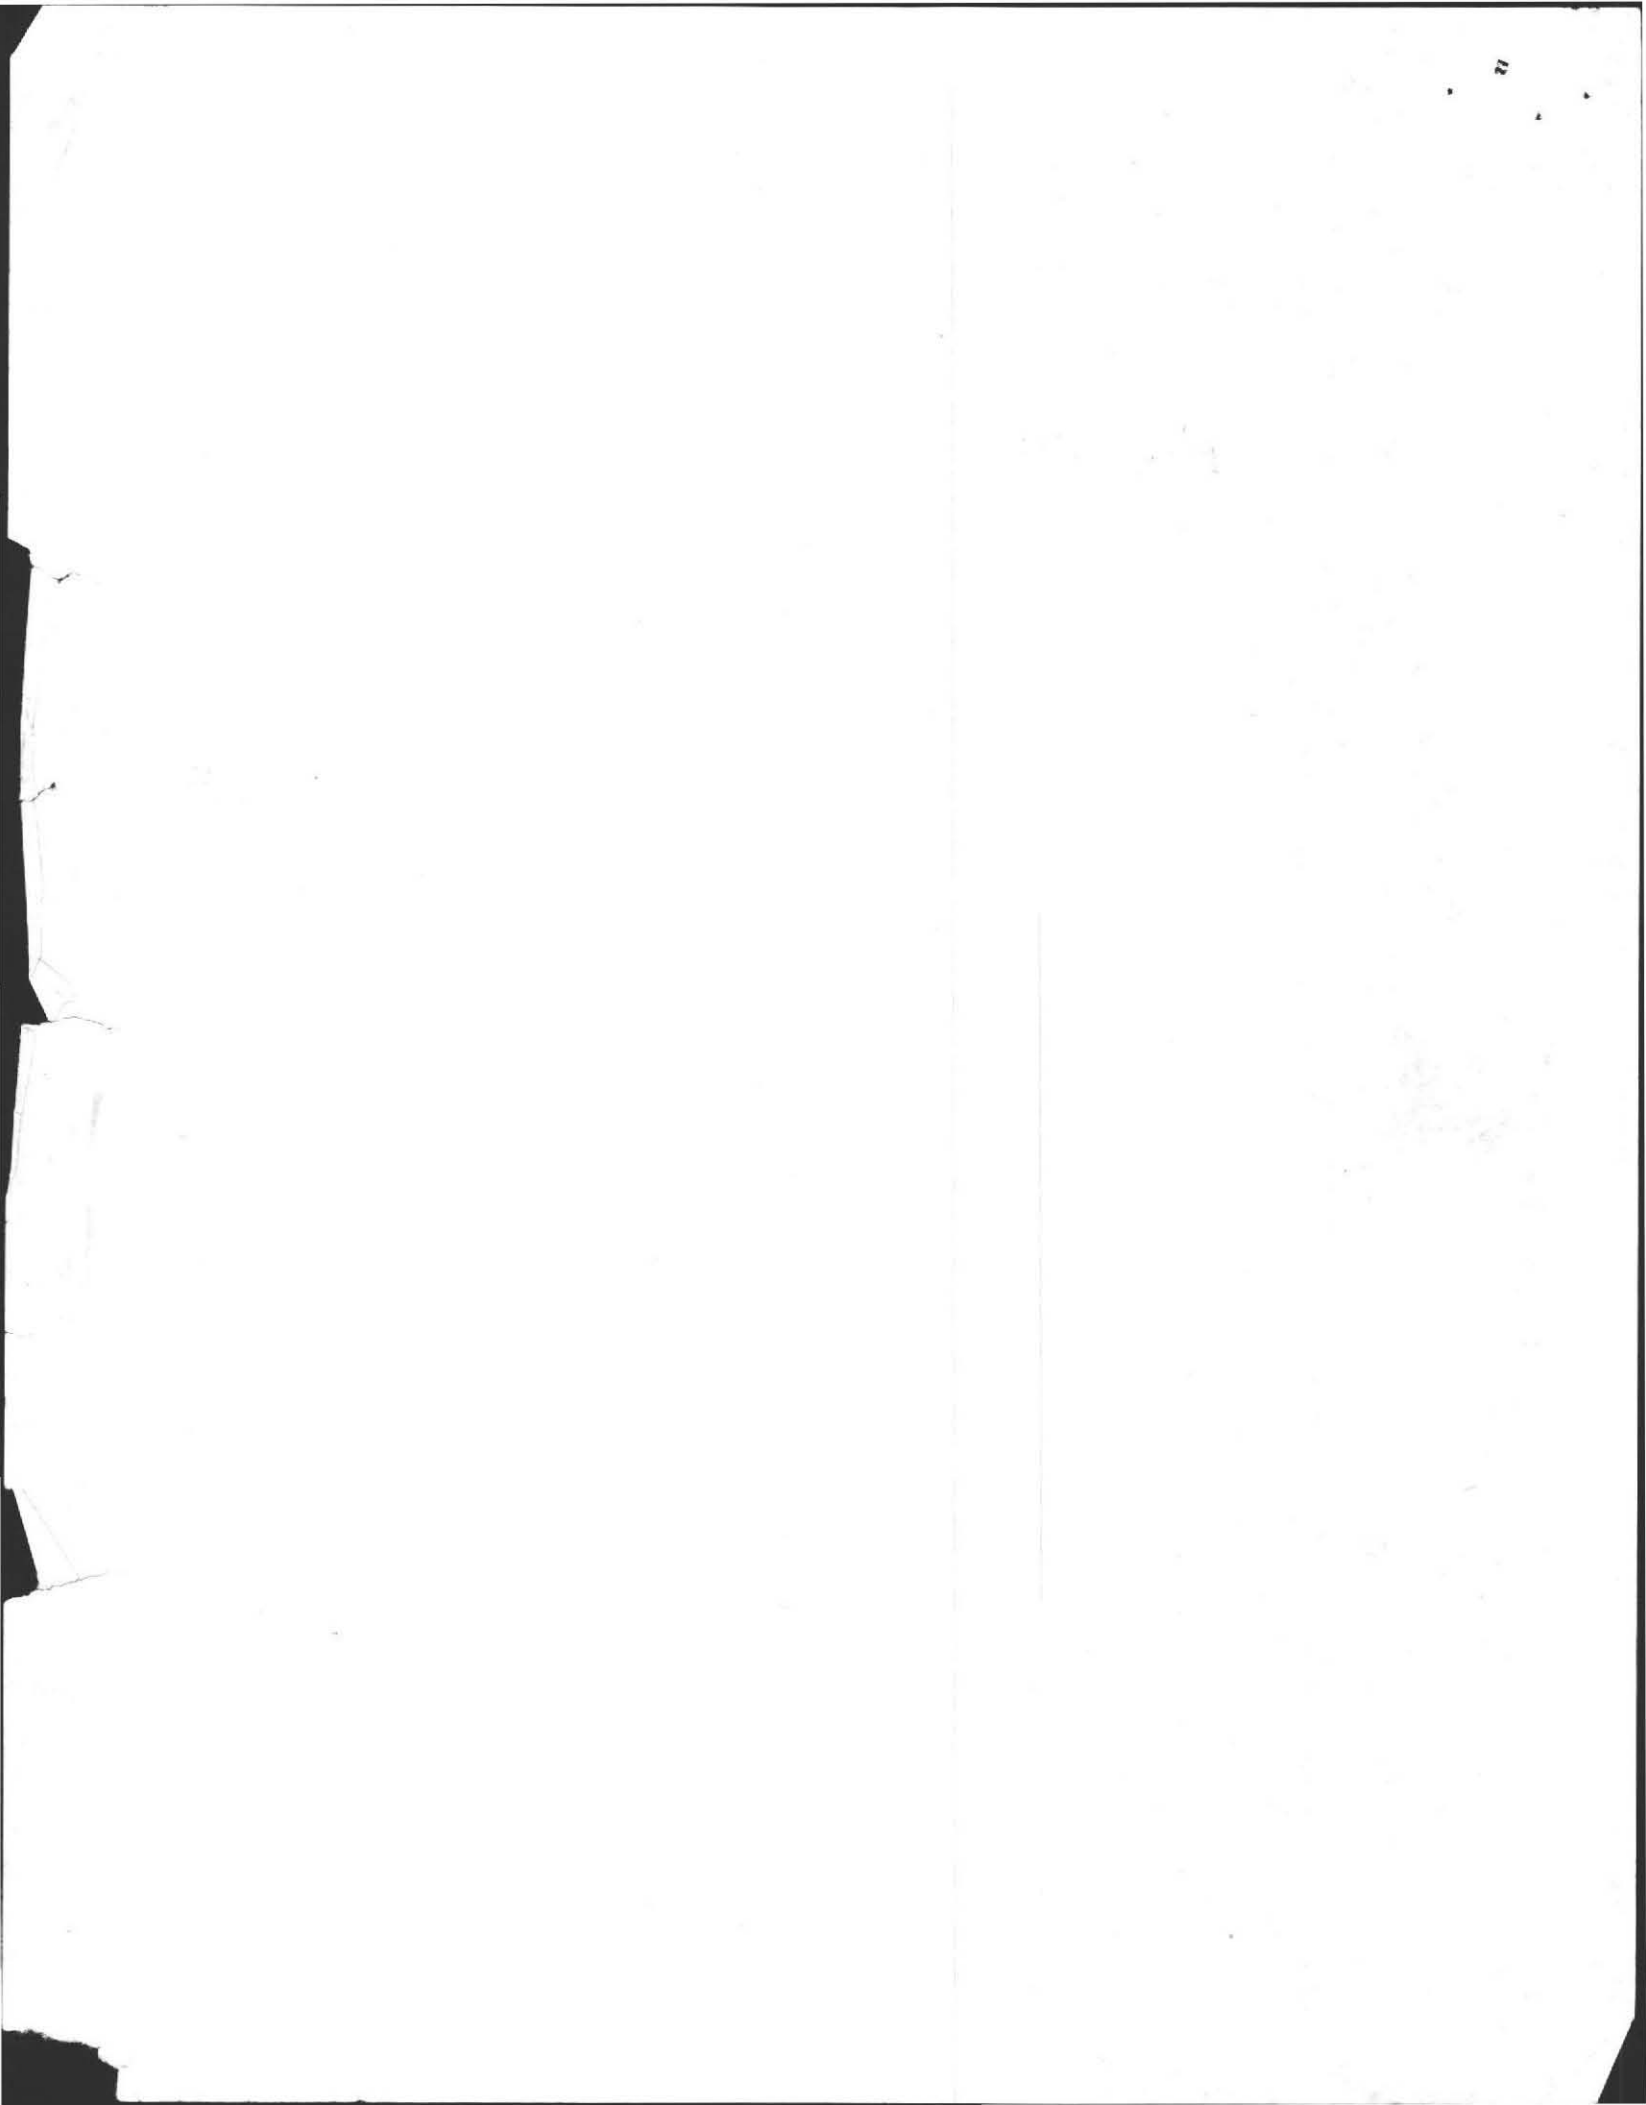

Scopus

BOARD OF HEALTH
TOWN OF AMHERST, MASSACHUSETTS

Important Information Regarding Your Private Sewage Disposal System

DISPLAY THIS DOCUMENT IN A PROMINENT PLACE

Owner JEFF FLOWER
~~ROBERT MAY~~ Address 9 MASS A SOU ST Hamp

Installer ROBERT DURKEE Address FLORENCE, MA.


Date Installation Inspected and Approved JUNE 12, 1978

Description of System: Tank Capacity: 1500

Leach Field () Bed () Seepage Pit () Square Feet: 700


Garbage Grinder Yes () No () No. Bedrooms: 4 No. People 8


AS - BUILT PLAN:

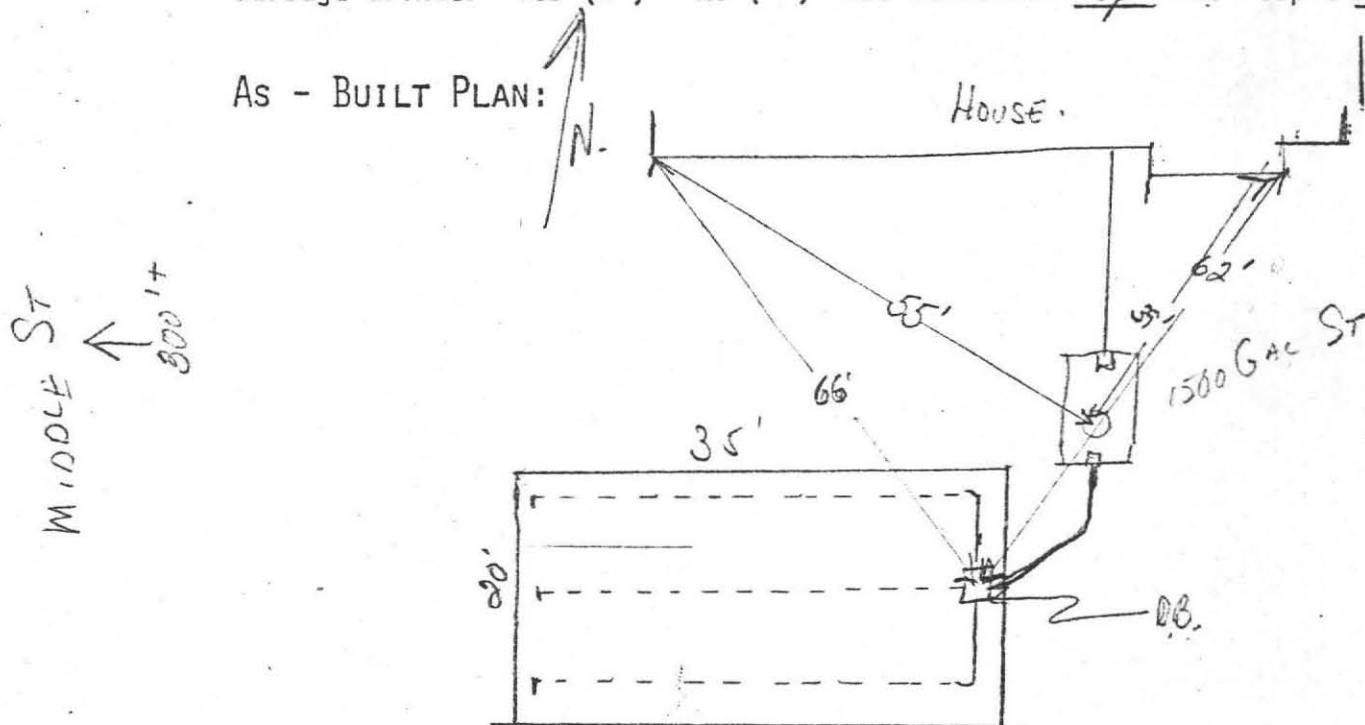

PROPER MAINTENANCE OF YOUR PRIVATE SEWAGE DISPOSAL SYSTEM

1. This system must be inspected periodically and the tank pumped out at an interval not to exceed 3 years.
2. For your protection sanitary pumpers are licensed by the Amherst Board of Health.
3. Regular pumping is crucial to avoid early failure and costly repairs of the system.
4. DO NOT dispose into the system such items as rags, string, sanitary napkins, coffee grounds as they can cause it to clog and fail.
5. Further information can be obtained by contacting your Health Department at 253-7077.

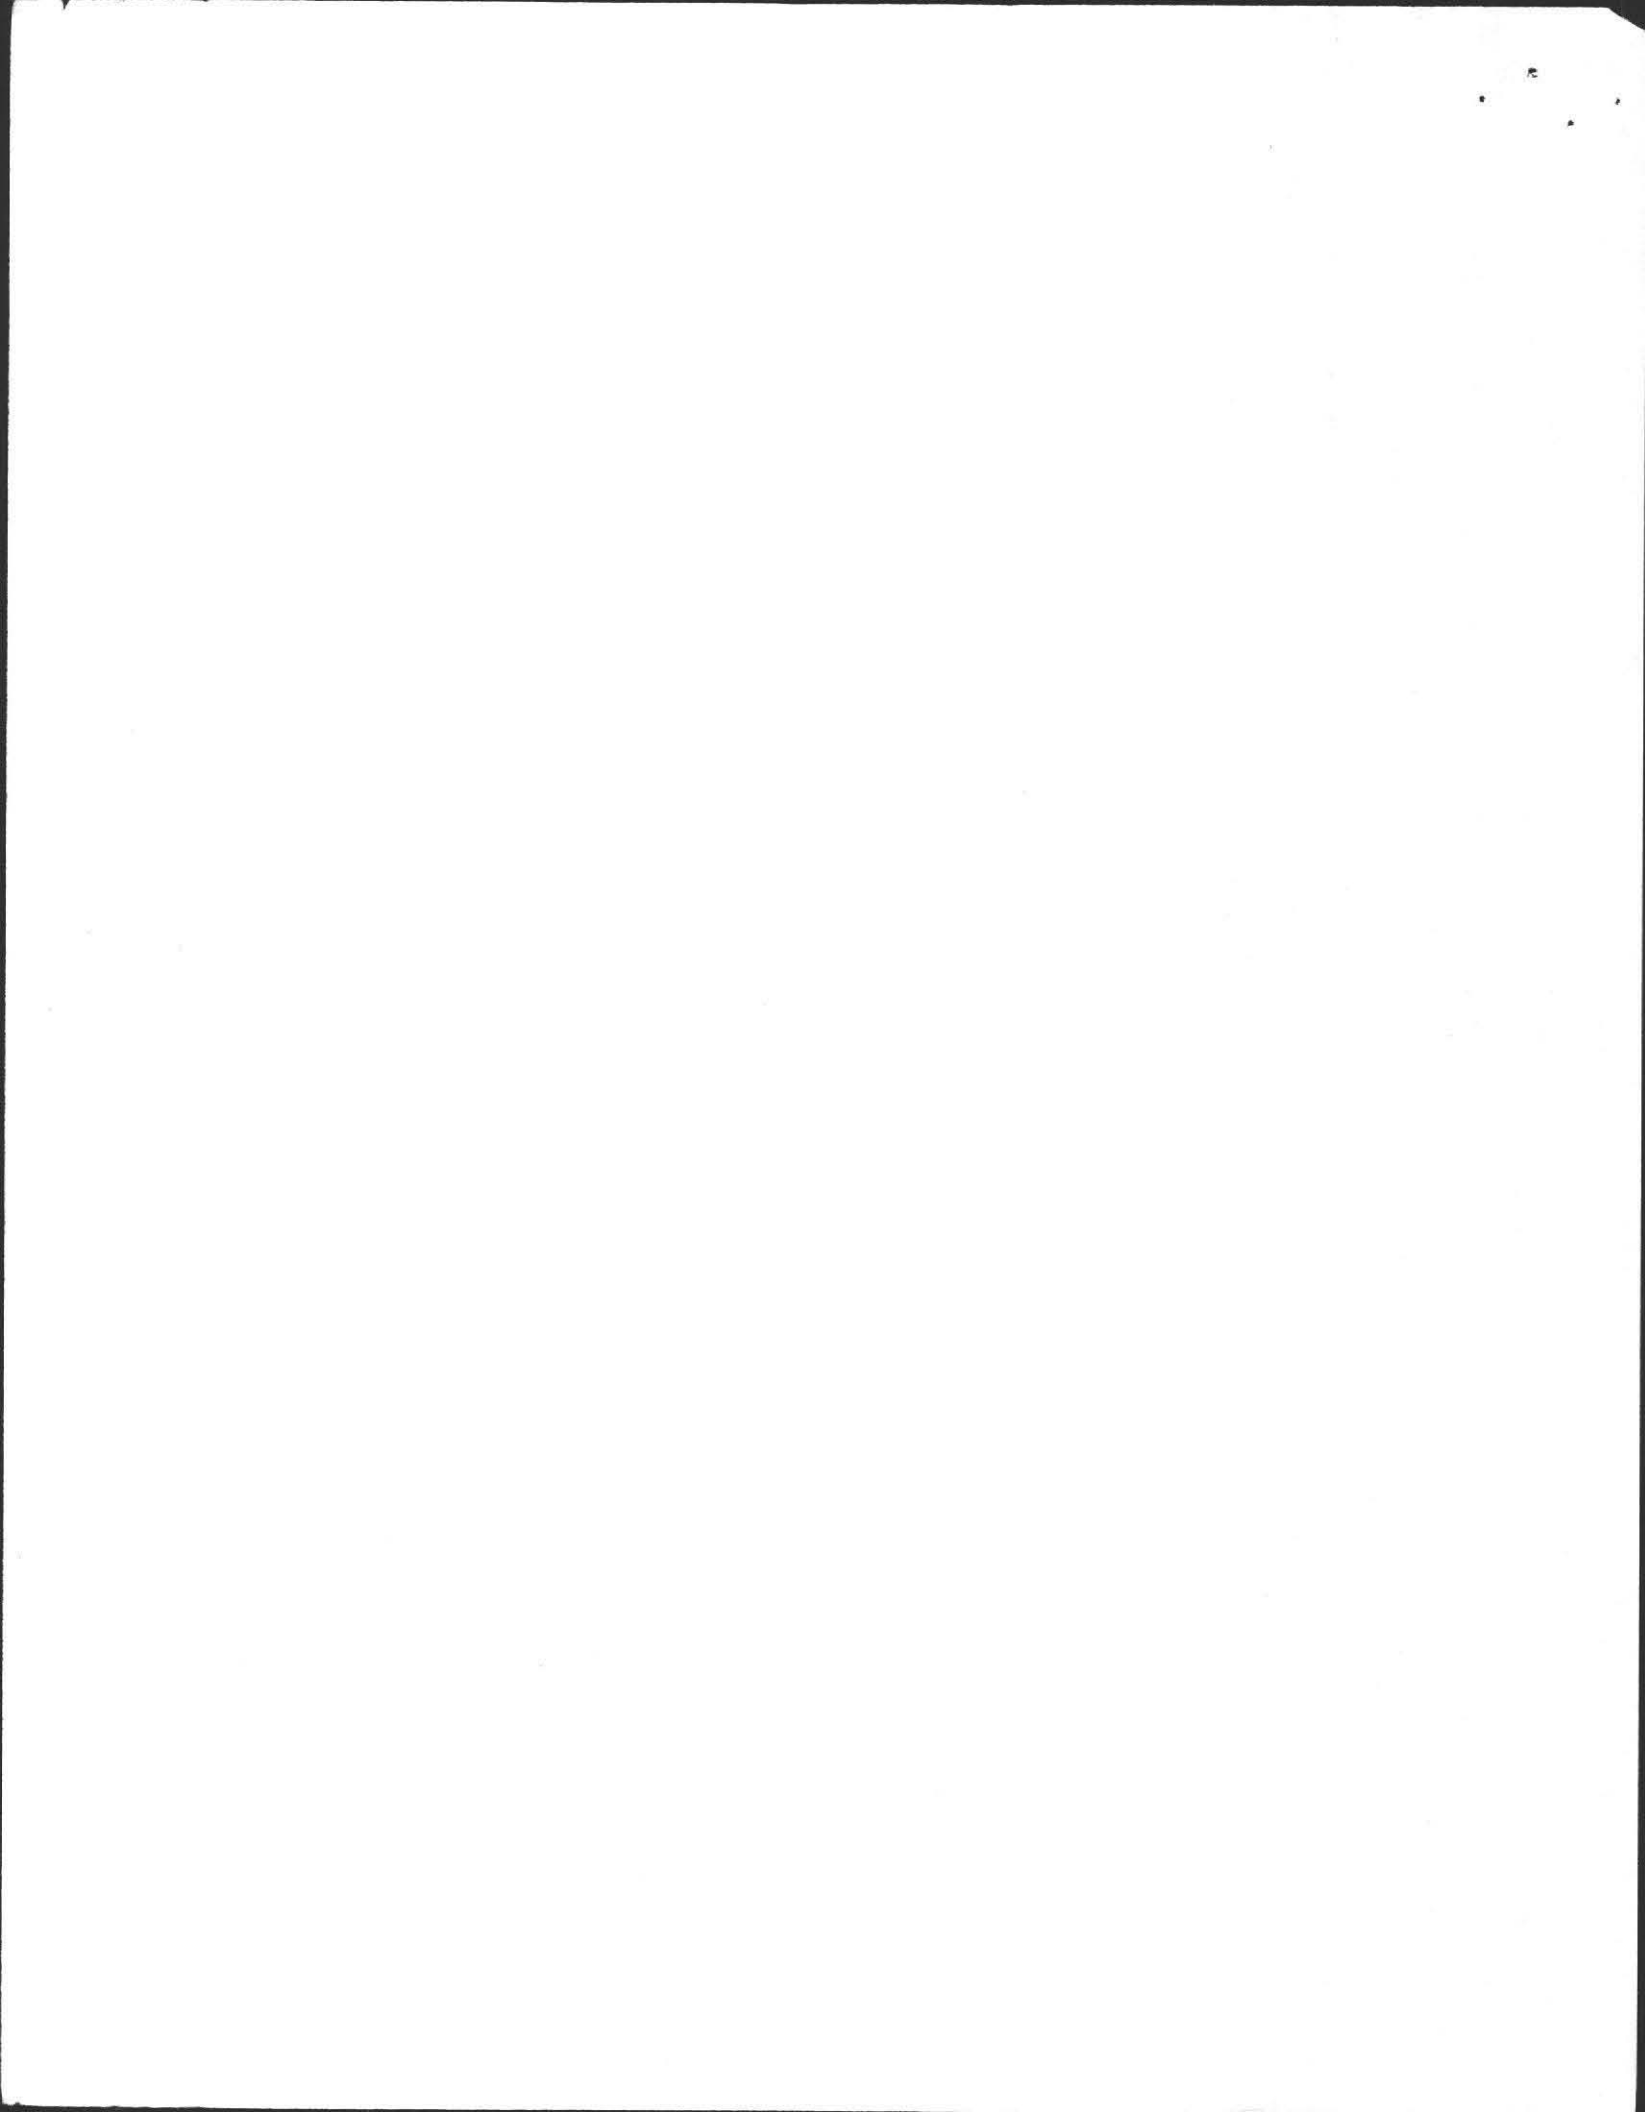


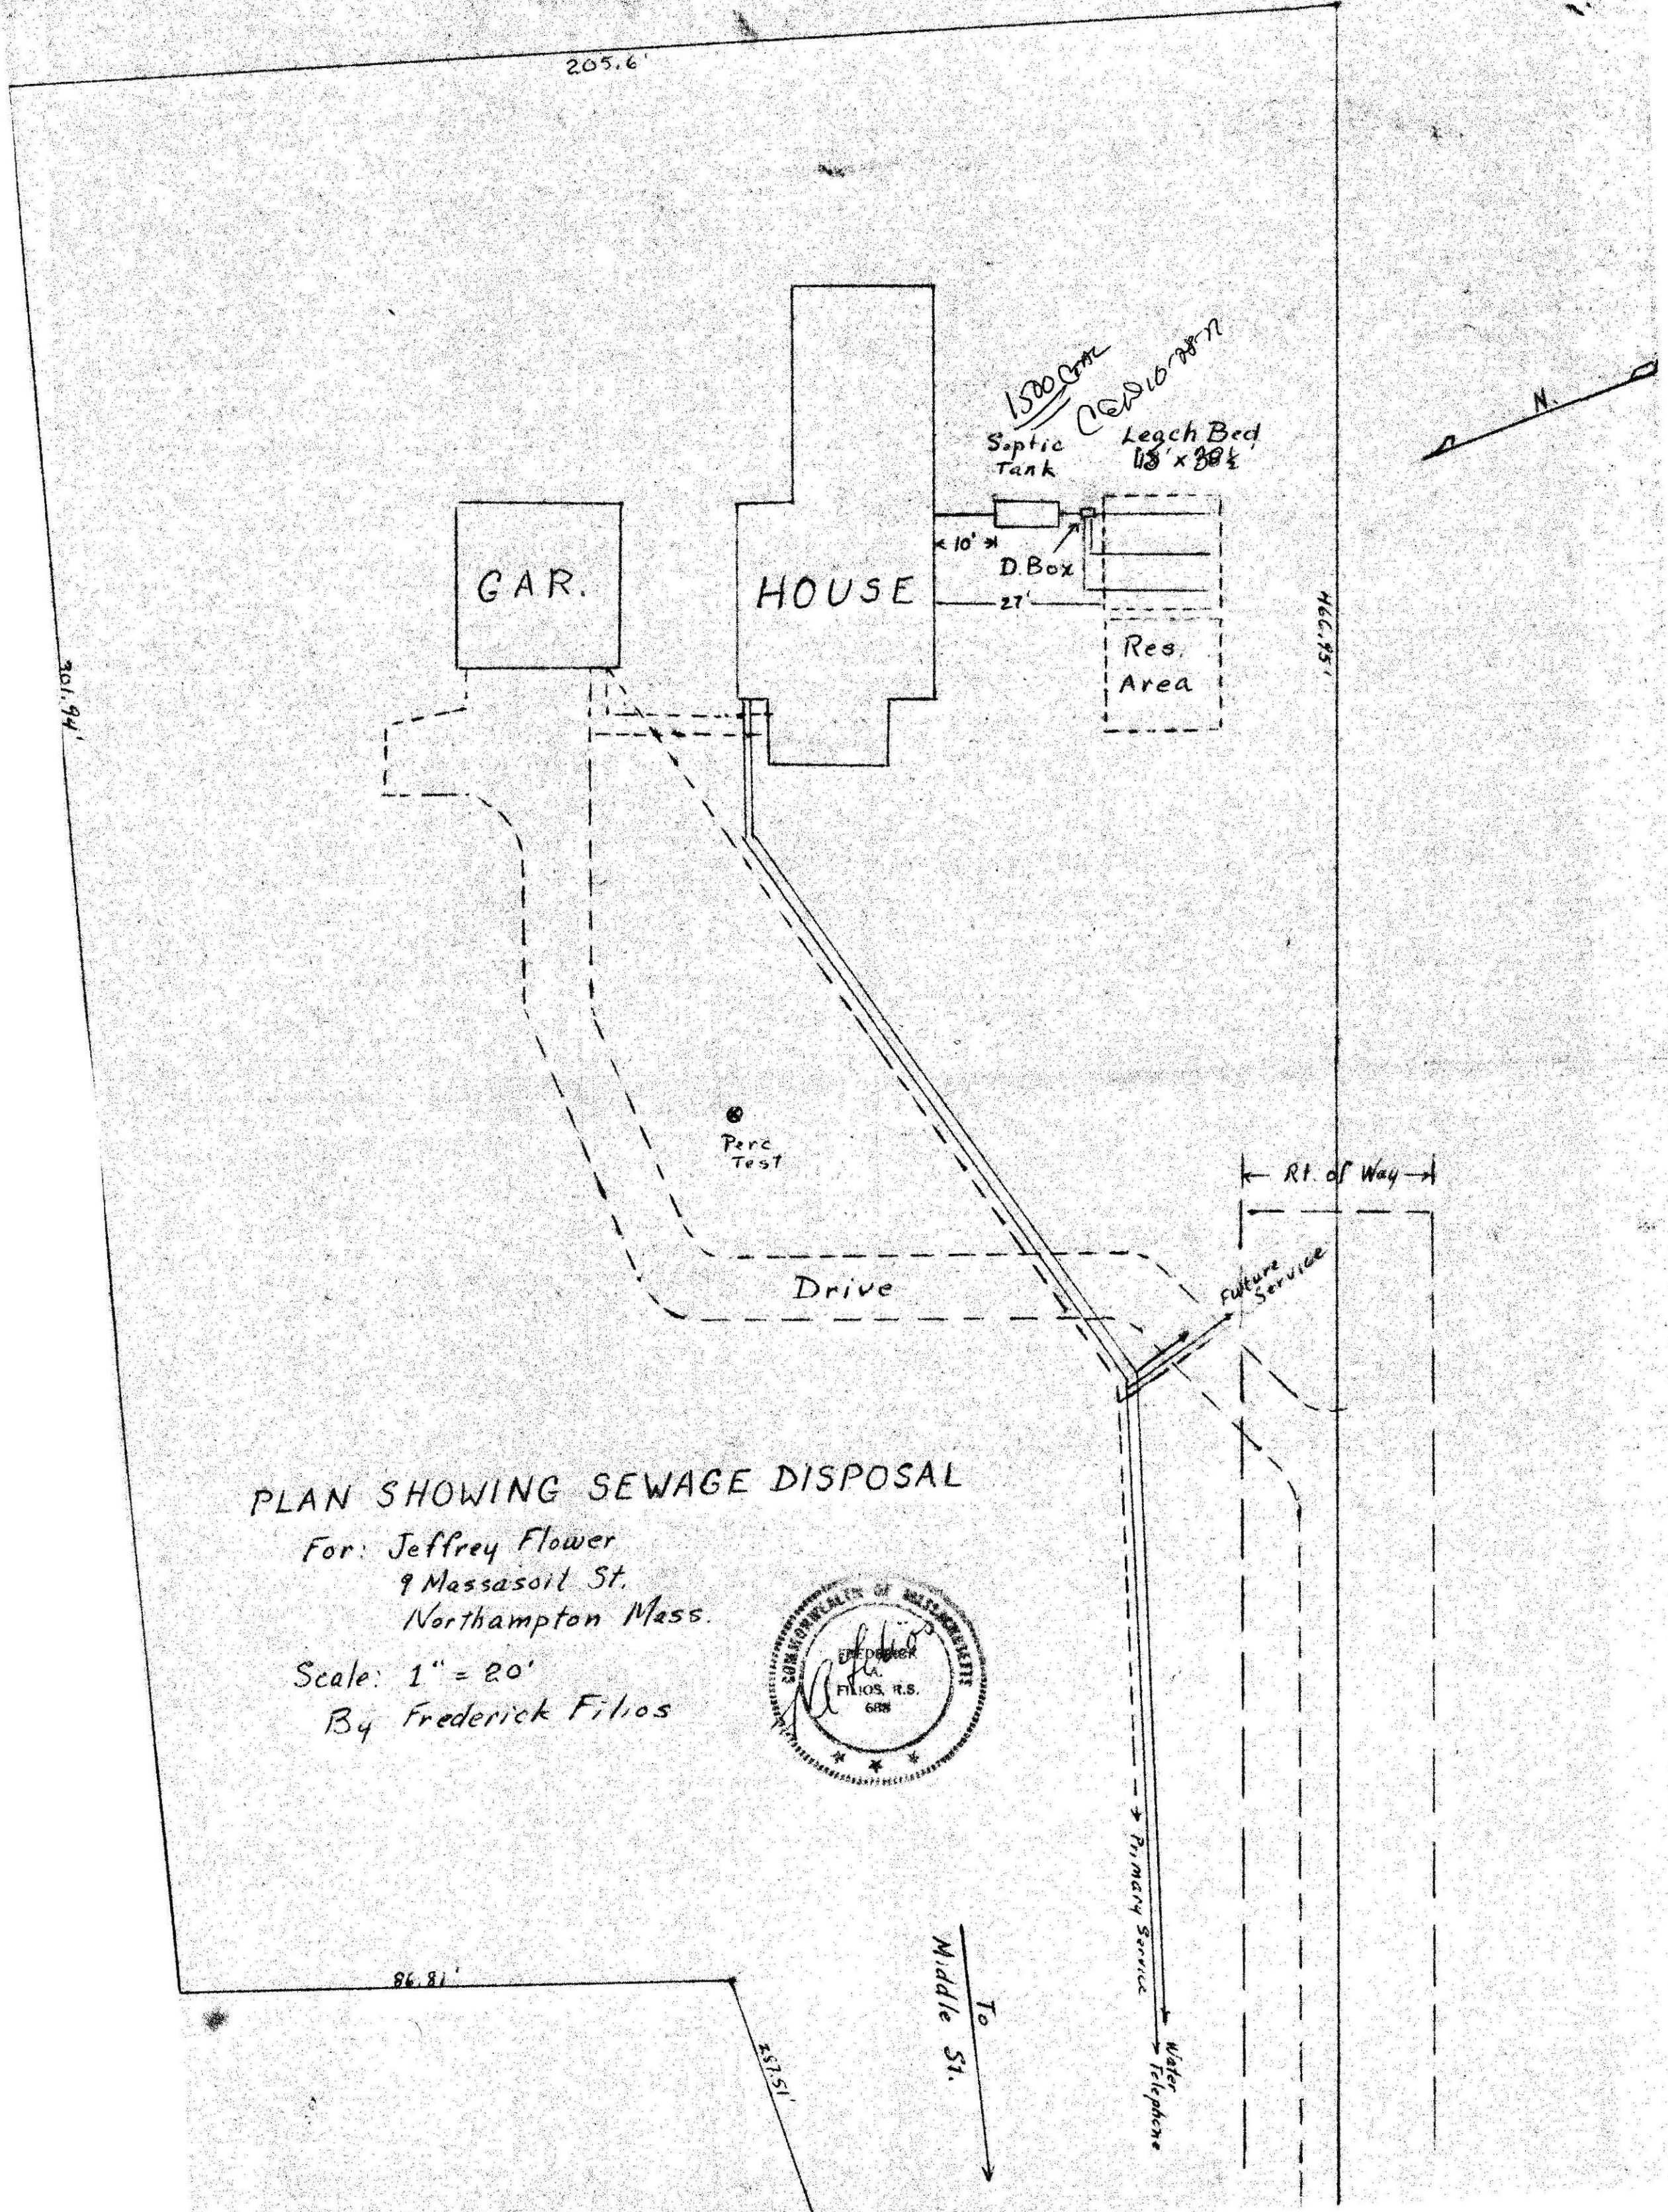

PLAN SHOWING SEWAGE DISPOSAL

For: Jeffrey Flower
 9 Massasoil St.
 Northampton Mass.

Scale: 1" = 20'
 By Frederick Filios

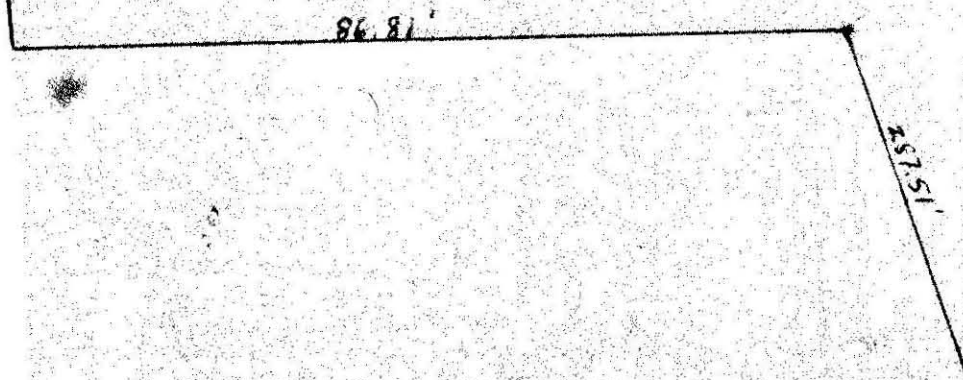

To
 Middle St.

Primary Service
 Water
 Telephone

Rt. of Way
 Future Service

