Water Service Connection

Address 62 KELLOGG AVE Inspector KS
Date of Inspection 1/19/2010 Contractor ROB ADMIR
Size of Main 6 Material CI Depth 5'
Pipe Material-Main to Shut Off CI Pipe Material-Shut Off to House PLASTIC FCT
Size of Service 3/4" Bedding Type TRG
Inspected and Approved to backfill YES Scale NTS
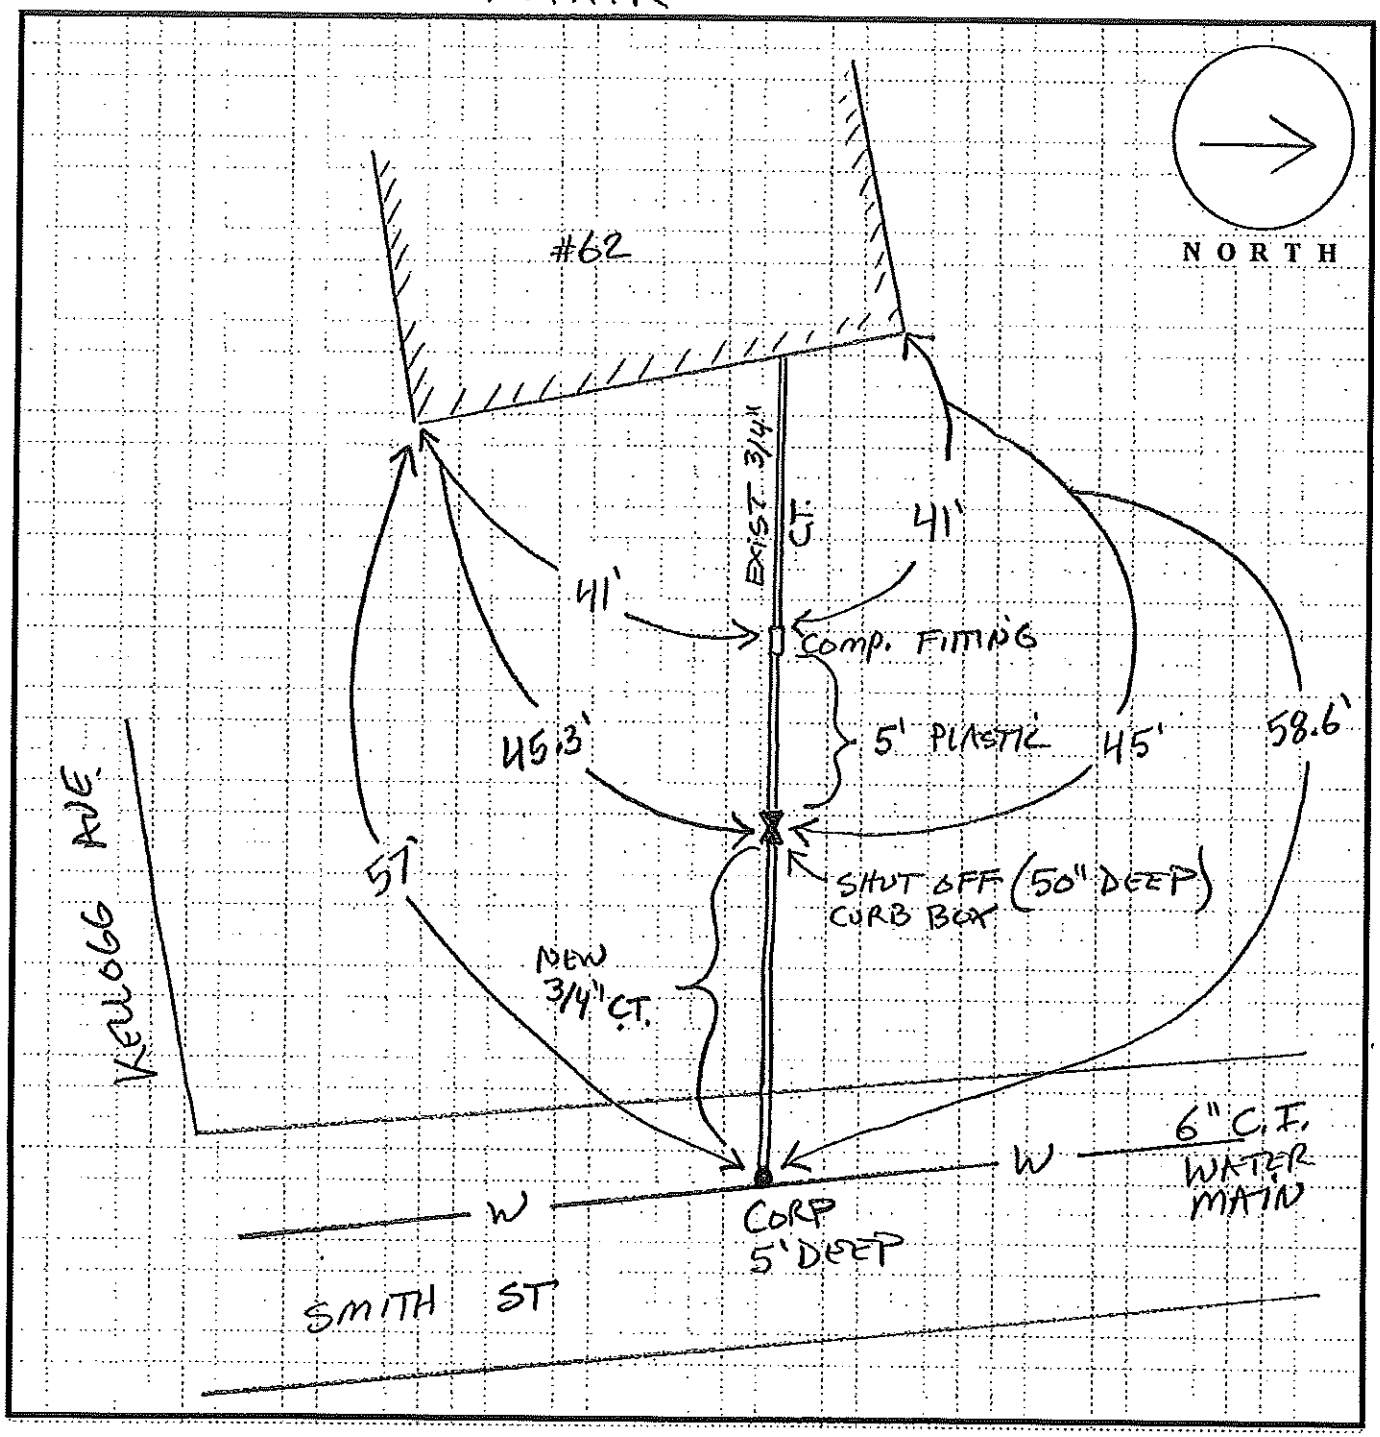
REPAIR