TOWN OF AMHERST
SERVICE REPAIR REPORT

DATE :
LEAK CLASSIFICATION :

NEAREST STREET ADDRESS
401 N. Pleasant

10-18-06
D.H.

BREAK APPEARS TO BE ON:	PIPE MATERIAL	COVER :	PERSONNEL
☐ Main	☐ Steel	☐ Concrete	
☐ Service	☐ Cast Iron	☐ Asphalt	
☐ Hydrant	☐ Ductile Iron	☐ Brick	
☐ Valve	☐ Asbestos Concrete	☐ Soil	
☐ Misc.	☐ Plastic	☐ Other	
	☐ Copper		
	☐ Galvanized		
	☐ Other		

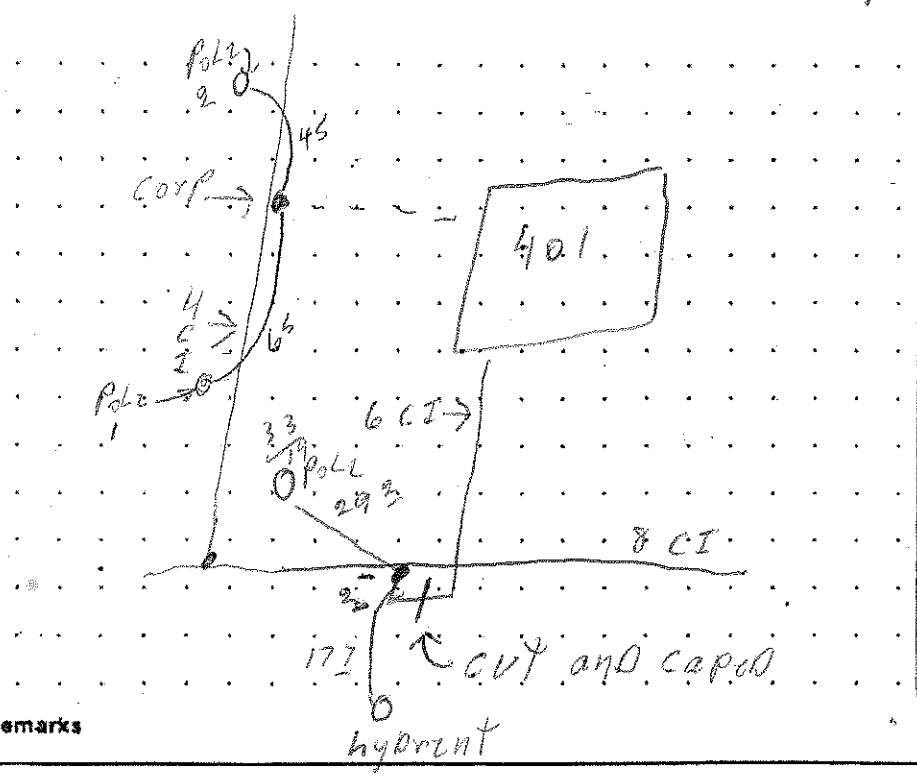

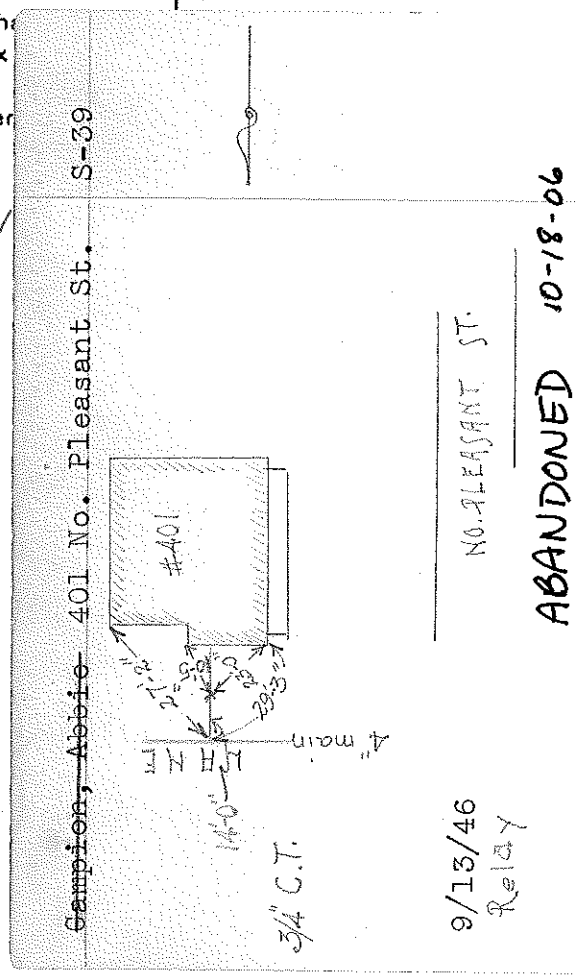

Remarks

close corp cut copper
sprinkler cut and capped 5ft bin pulp

SUPERVISOR