Hallcourt Gardens North on Hallock Street

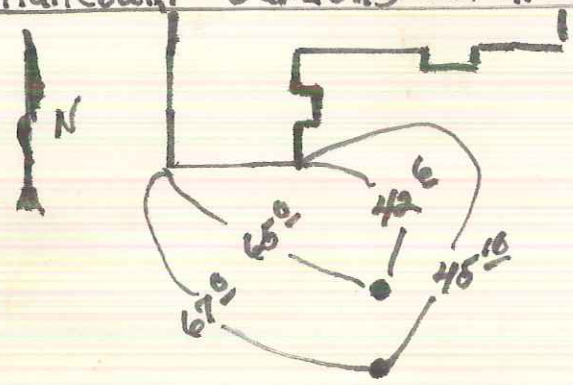

1½ CT
Relaid
To New
8" AC
Main
10-14-77

8" AC 5 Feet Deep
1½" Saddle Tap 2" Sq Nut Gate For Curb