Halcourt Gardens, 26 Hallock St.

S-316
A-354

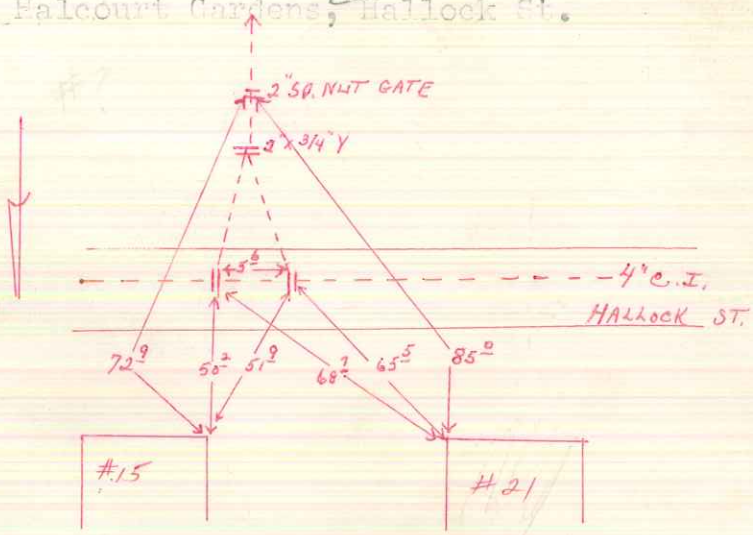

6/5/63
2 - 3/4" TAPS

Halcourt Gardens Apt.
26 Hallock St.

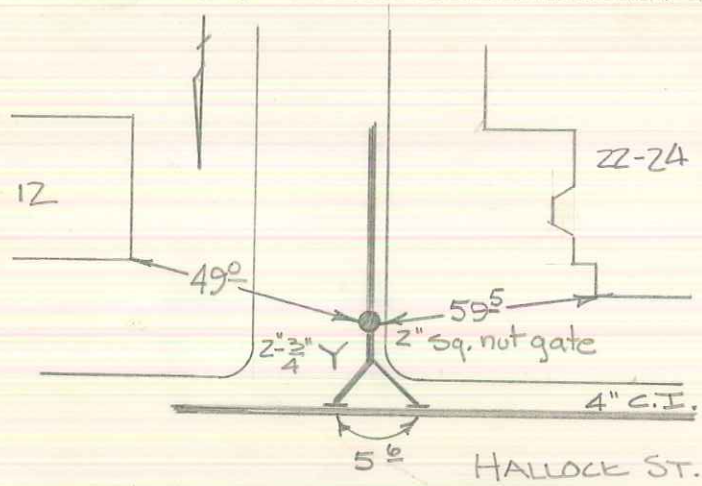

8-19-76
REMEASURE
2-3/4" taps

Halcourt Gardens South

10.18.77

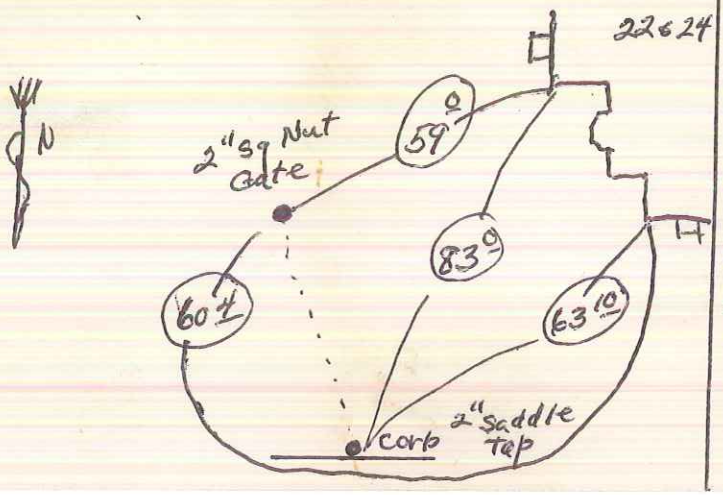

2" CT Service Goes Under Sewer Drain And Old Main